


1 NORTH EAST ELEVATION
1 : 100

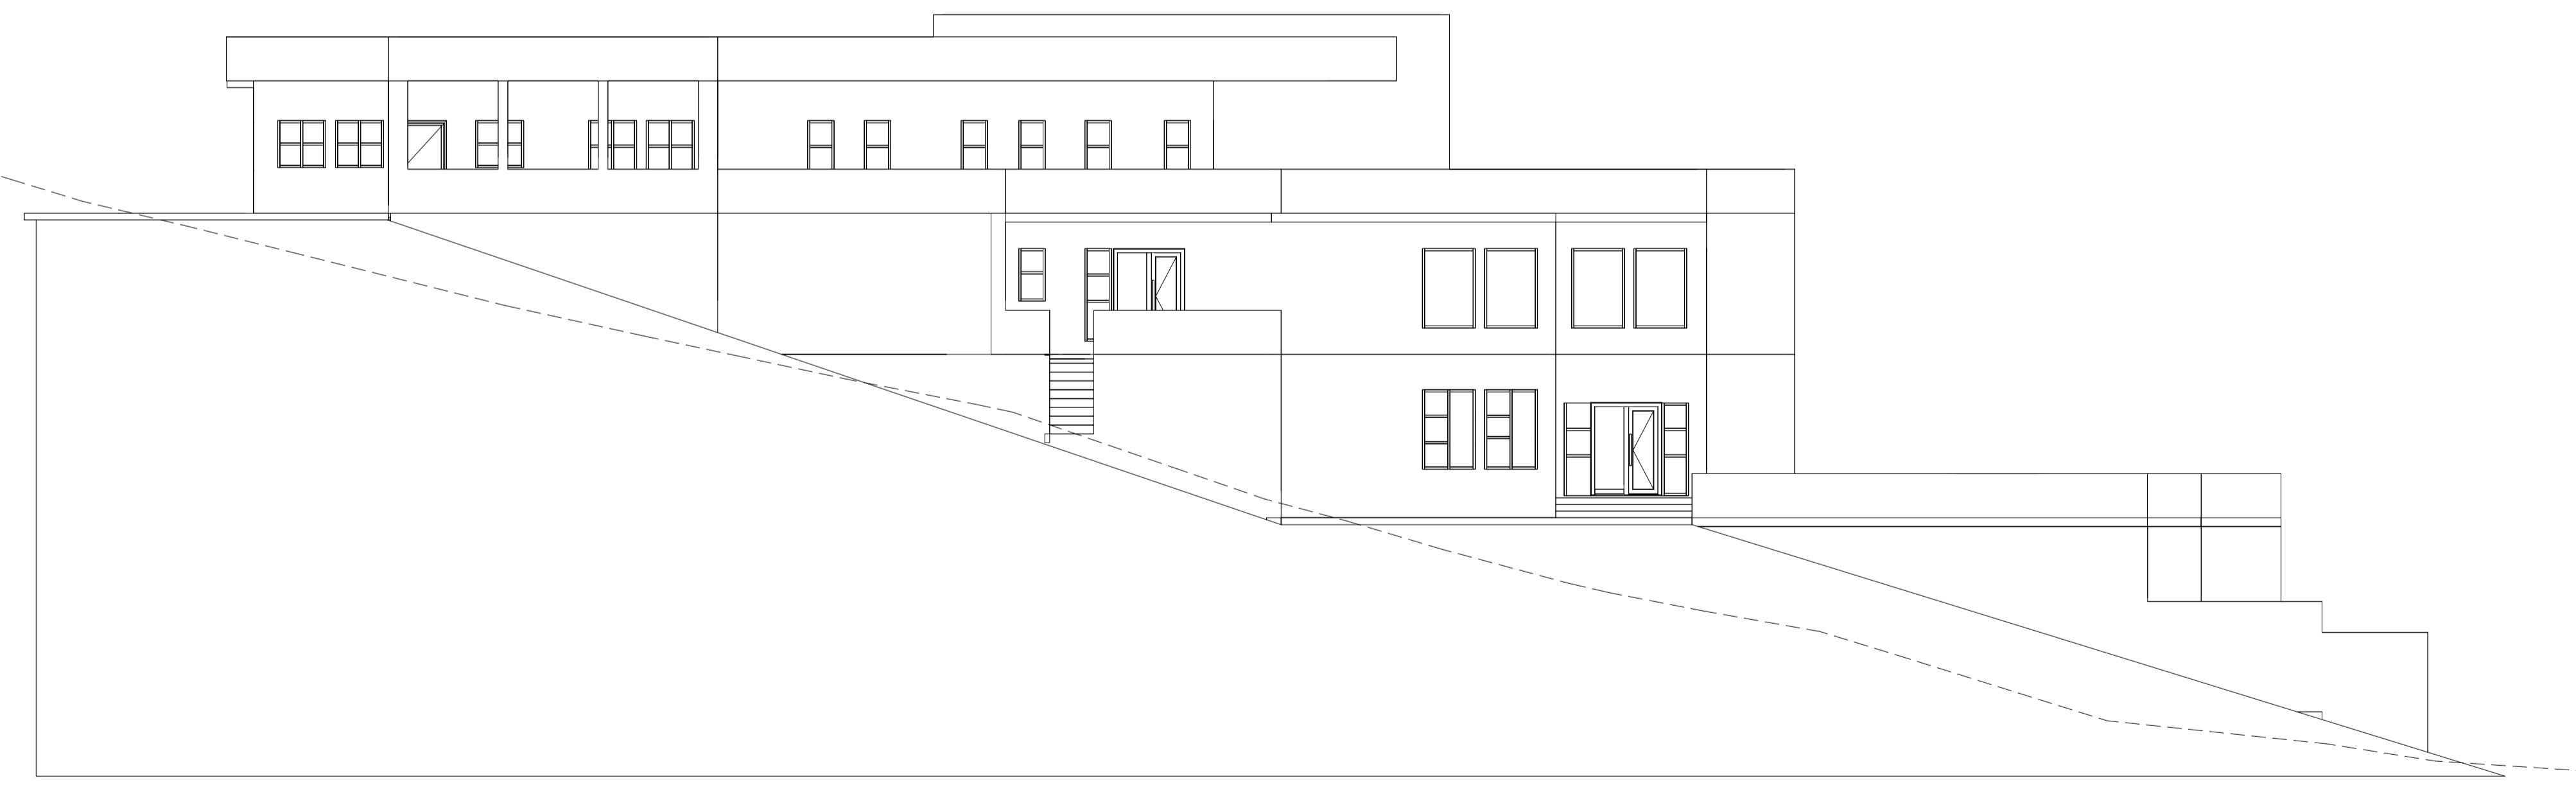

2 SOUTH WEST ELEVATION
1 : 100

DRAWING TITLE:
FOR MUNICIPAL SUBMISSION
NORTH EAST ELEVATION , SOUTH WEST ELEVATION

GENERAL NOTES:
1. ALL DIMENSIONS TO BE CHECKED ON SITE BEFORE ANY WORK IS PUT IN HAND.
2. THIS DRAWING TO BE READ IN CONJUNCTION WITH ENGINEER'S DRAWINGS.
3. UNDER NO CIRCUMSTANCES MAY DIMENSIONS BE SCALED FROM THIS DRAWING.
4. ANY DISCREPANCIES ARE TO BE REPORTED TO THE DESIGNERS IMMEDIATELY.

COPYRIGHT AND RIGHT OF REPRODUCTION OF THIS DRAWING OR ANY PORTION THEREOF IS RESERVED BY THE DESIGNER

CLIENT:
Li-Yi Chen &
Chia-Jung Chang
P.O.BOX
PIONIERSPARK
+264 81 288 0708

PROJECT TITLE:
AS BUILT DRAWINGS
WINDOW & DOOR CORRECTIONS

DATE:
05/05/2023

SCALE @ A1: AS SHOWN	CHECKED BY: LAMUTENYA
CLIENT APPROVED: Y	DRAWN BY: LAMUTENYA
DRAWING NUMBER	REV:

L.A DESIGNS
LANDULENI AMUTENYA
P O Box 6933
Ausspannplatz
l.a.designsnam@gmail.com