



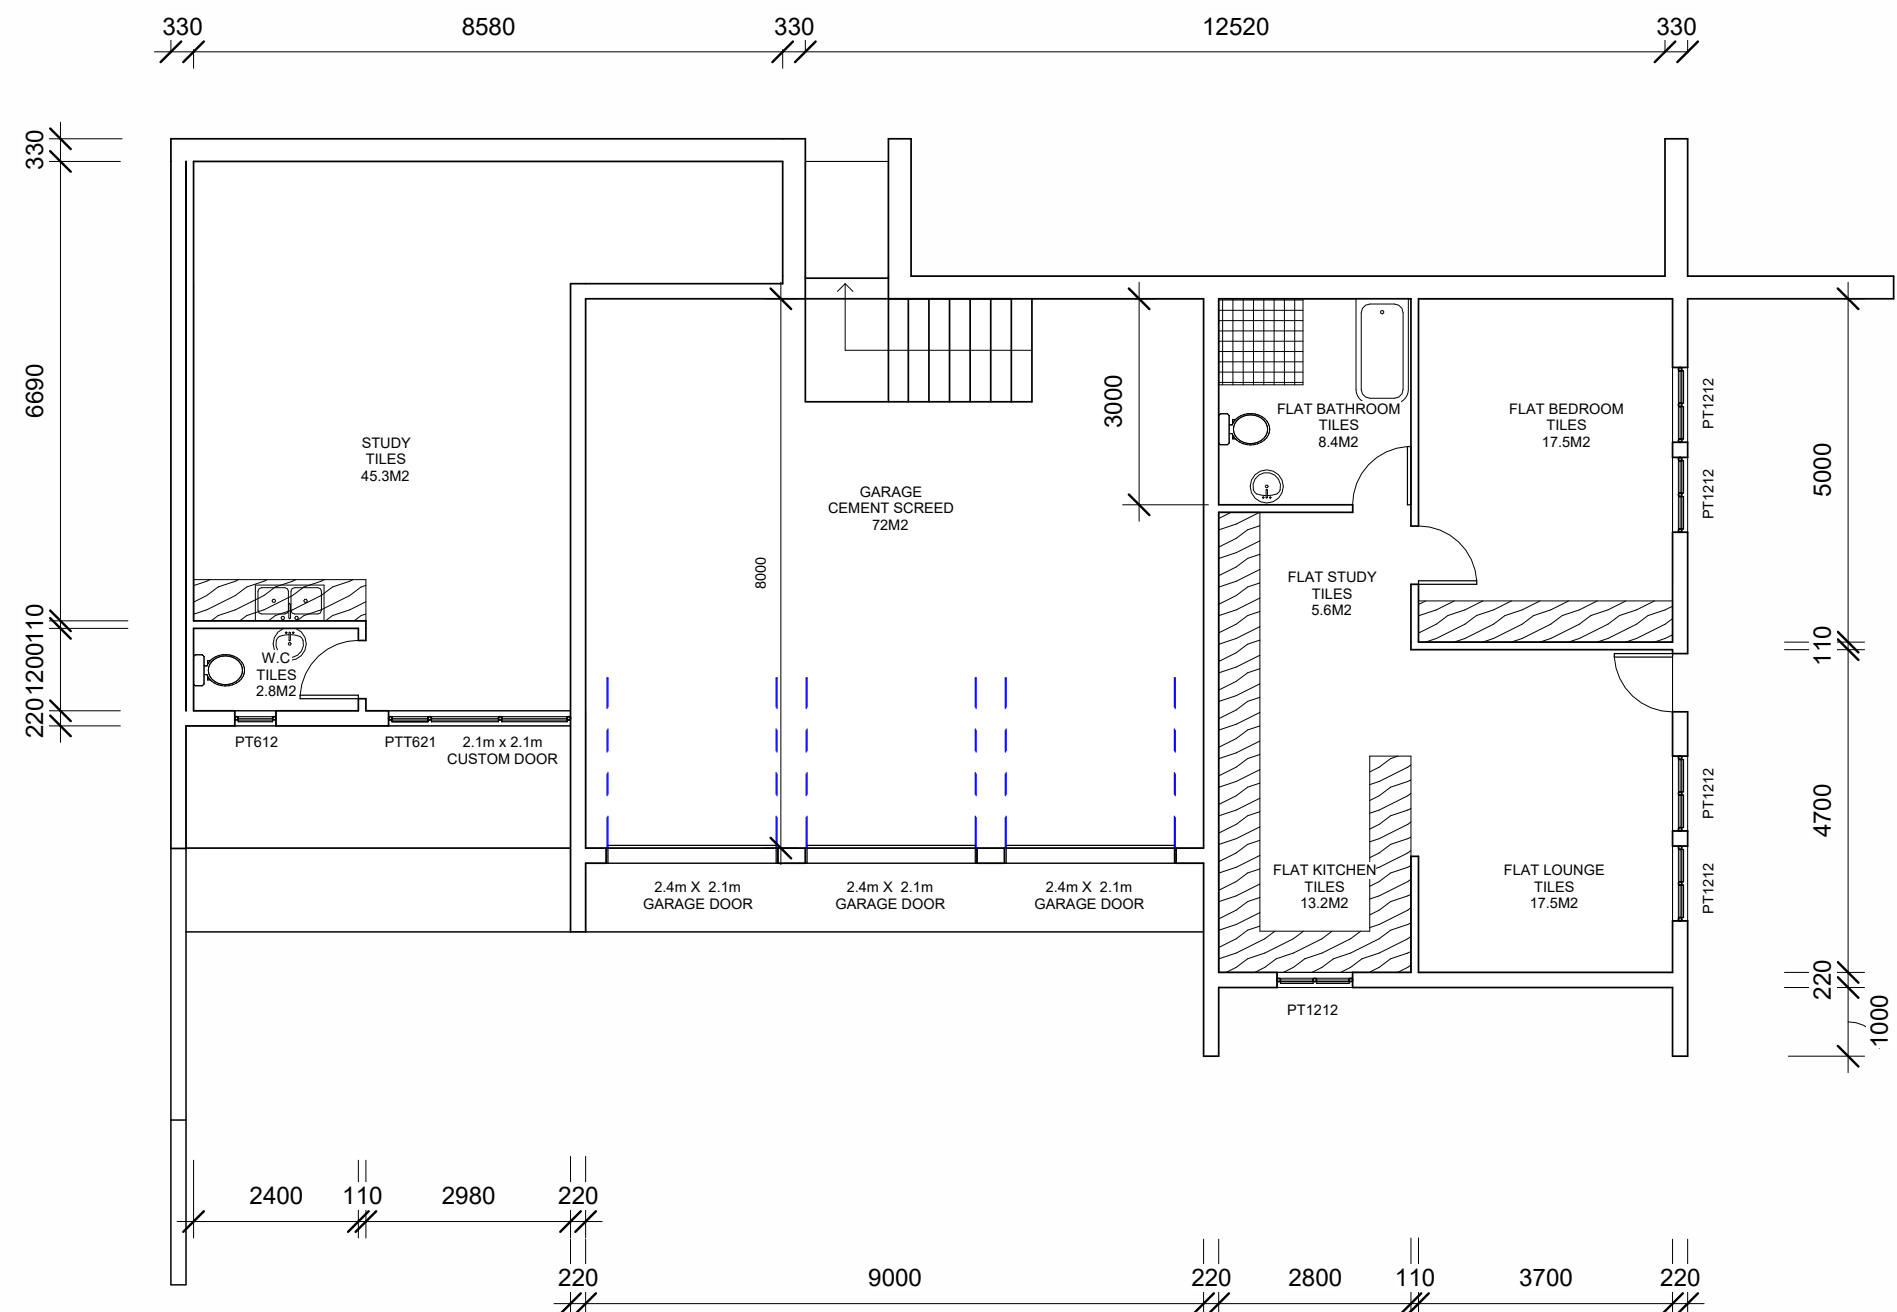


1 LOWER FLOOR

1 : 100

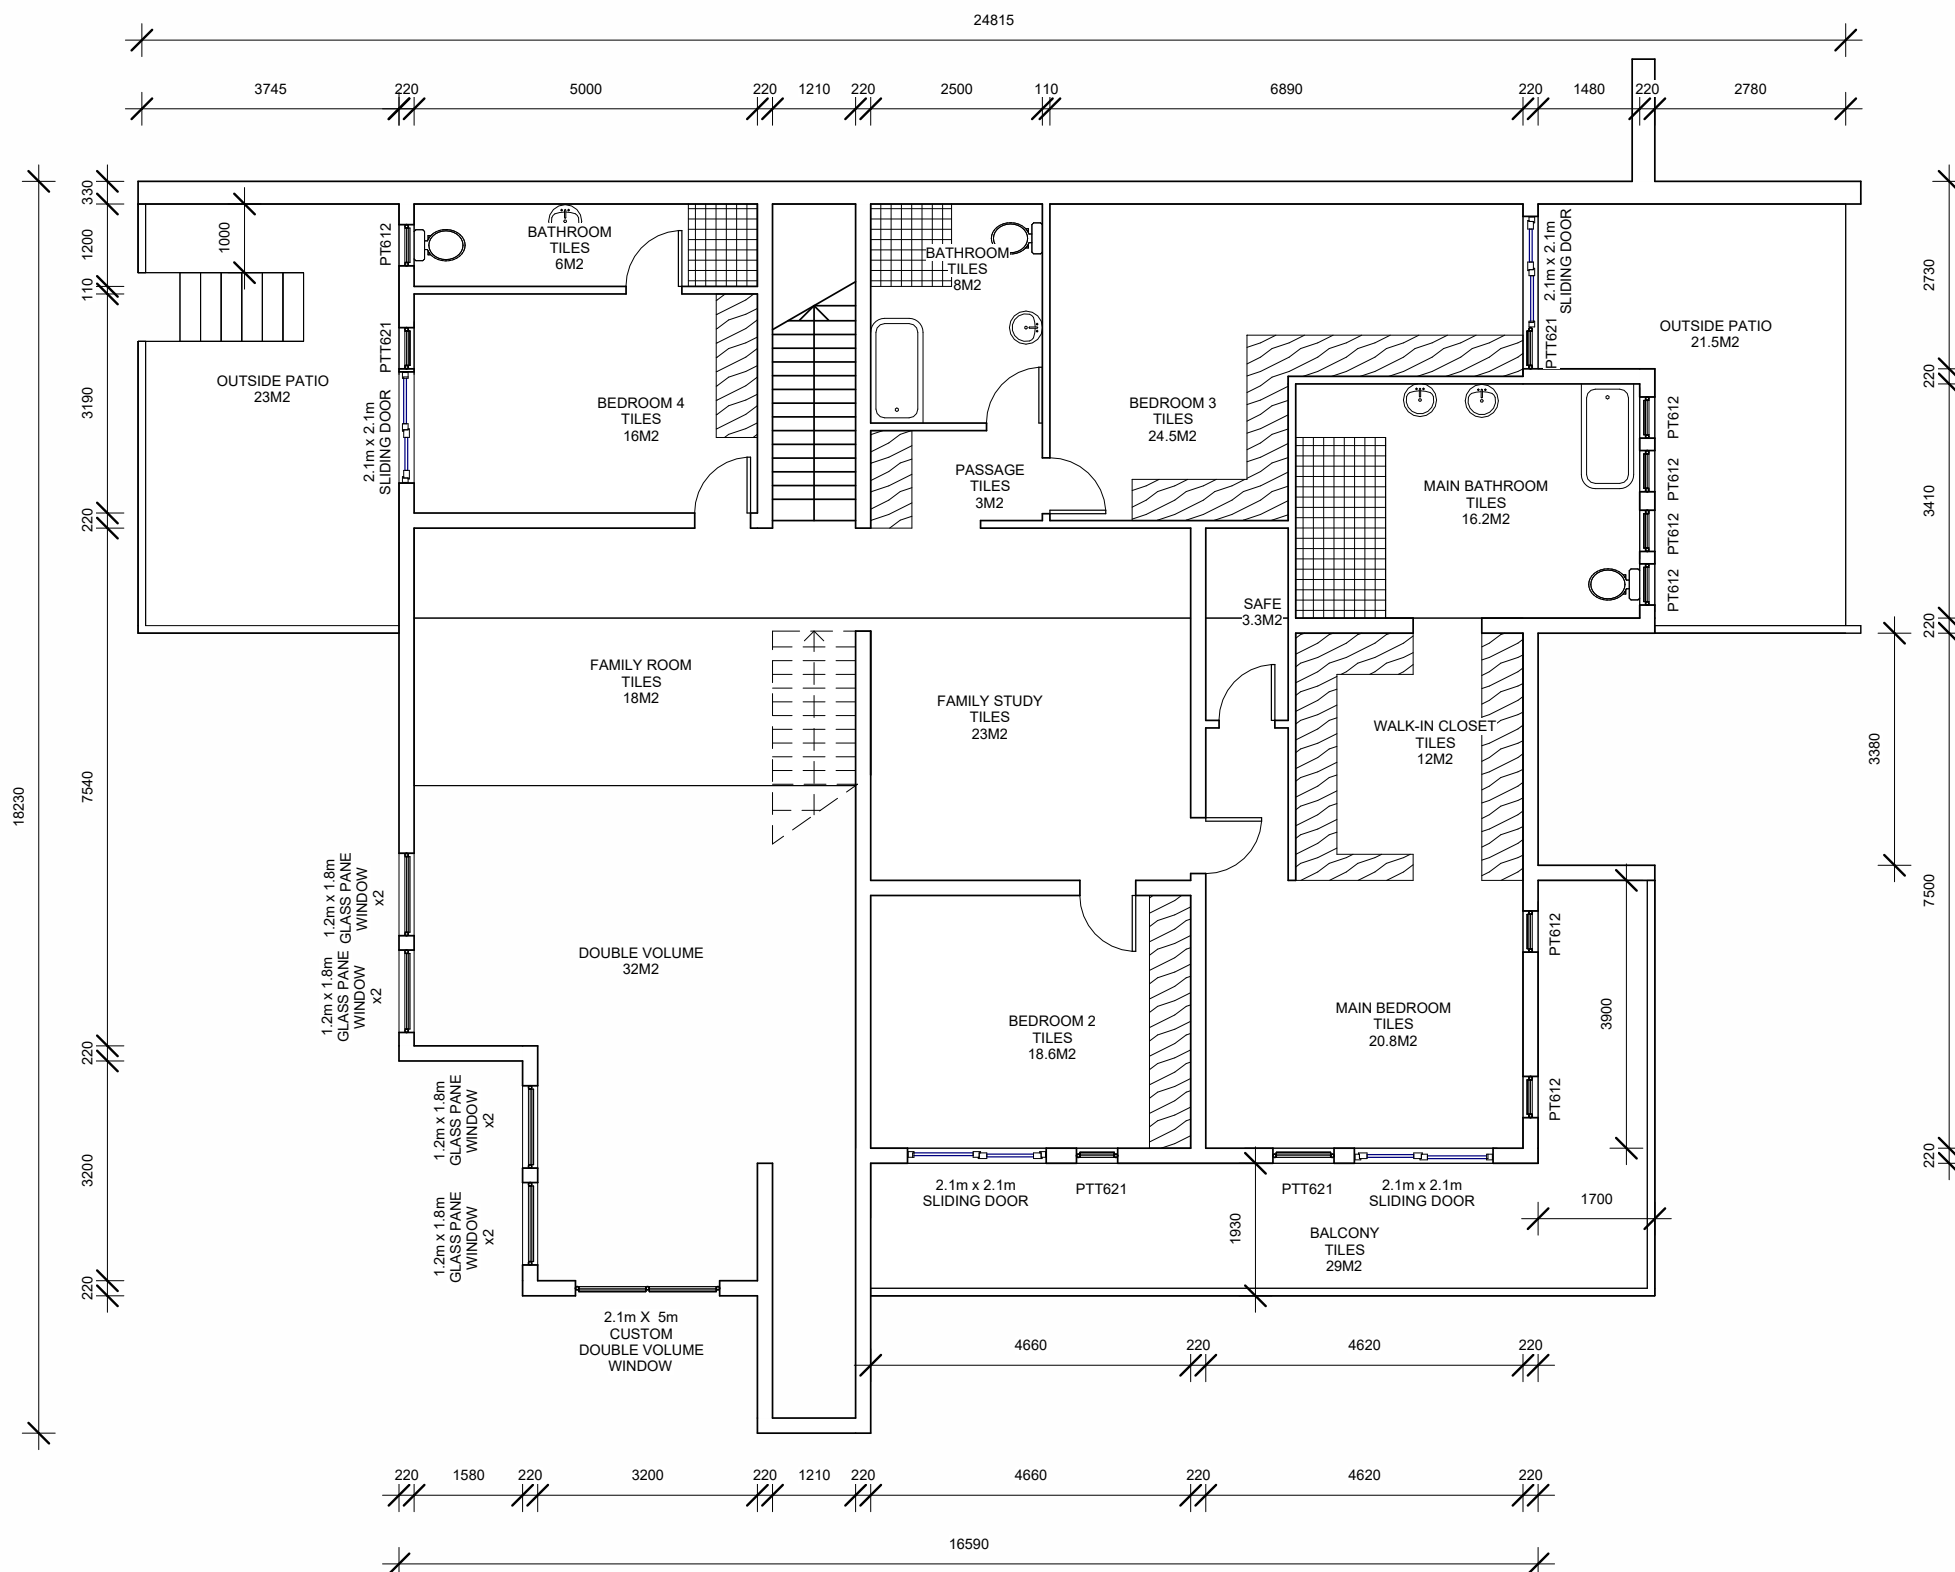


3 FIRST FLOOR

1 : 100

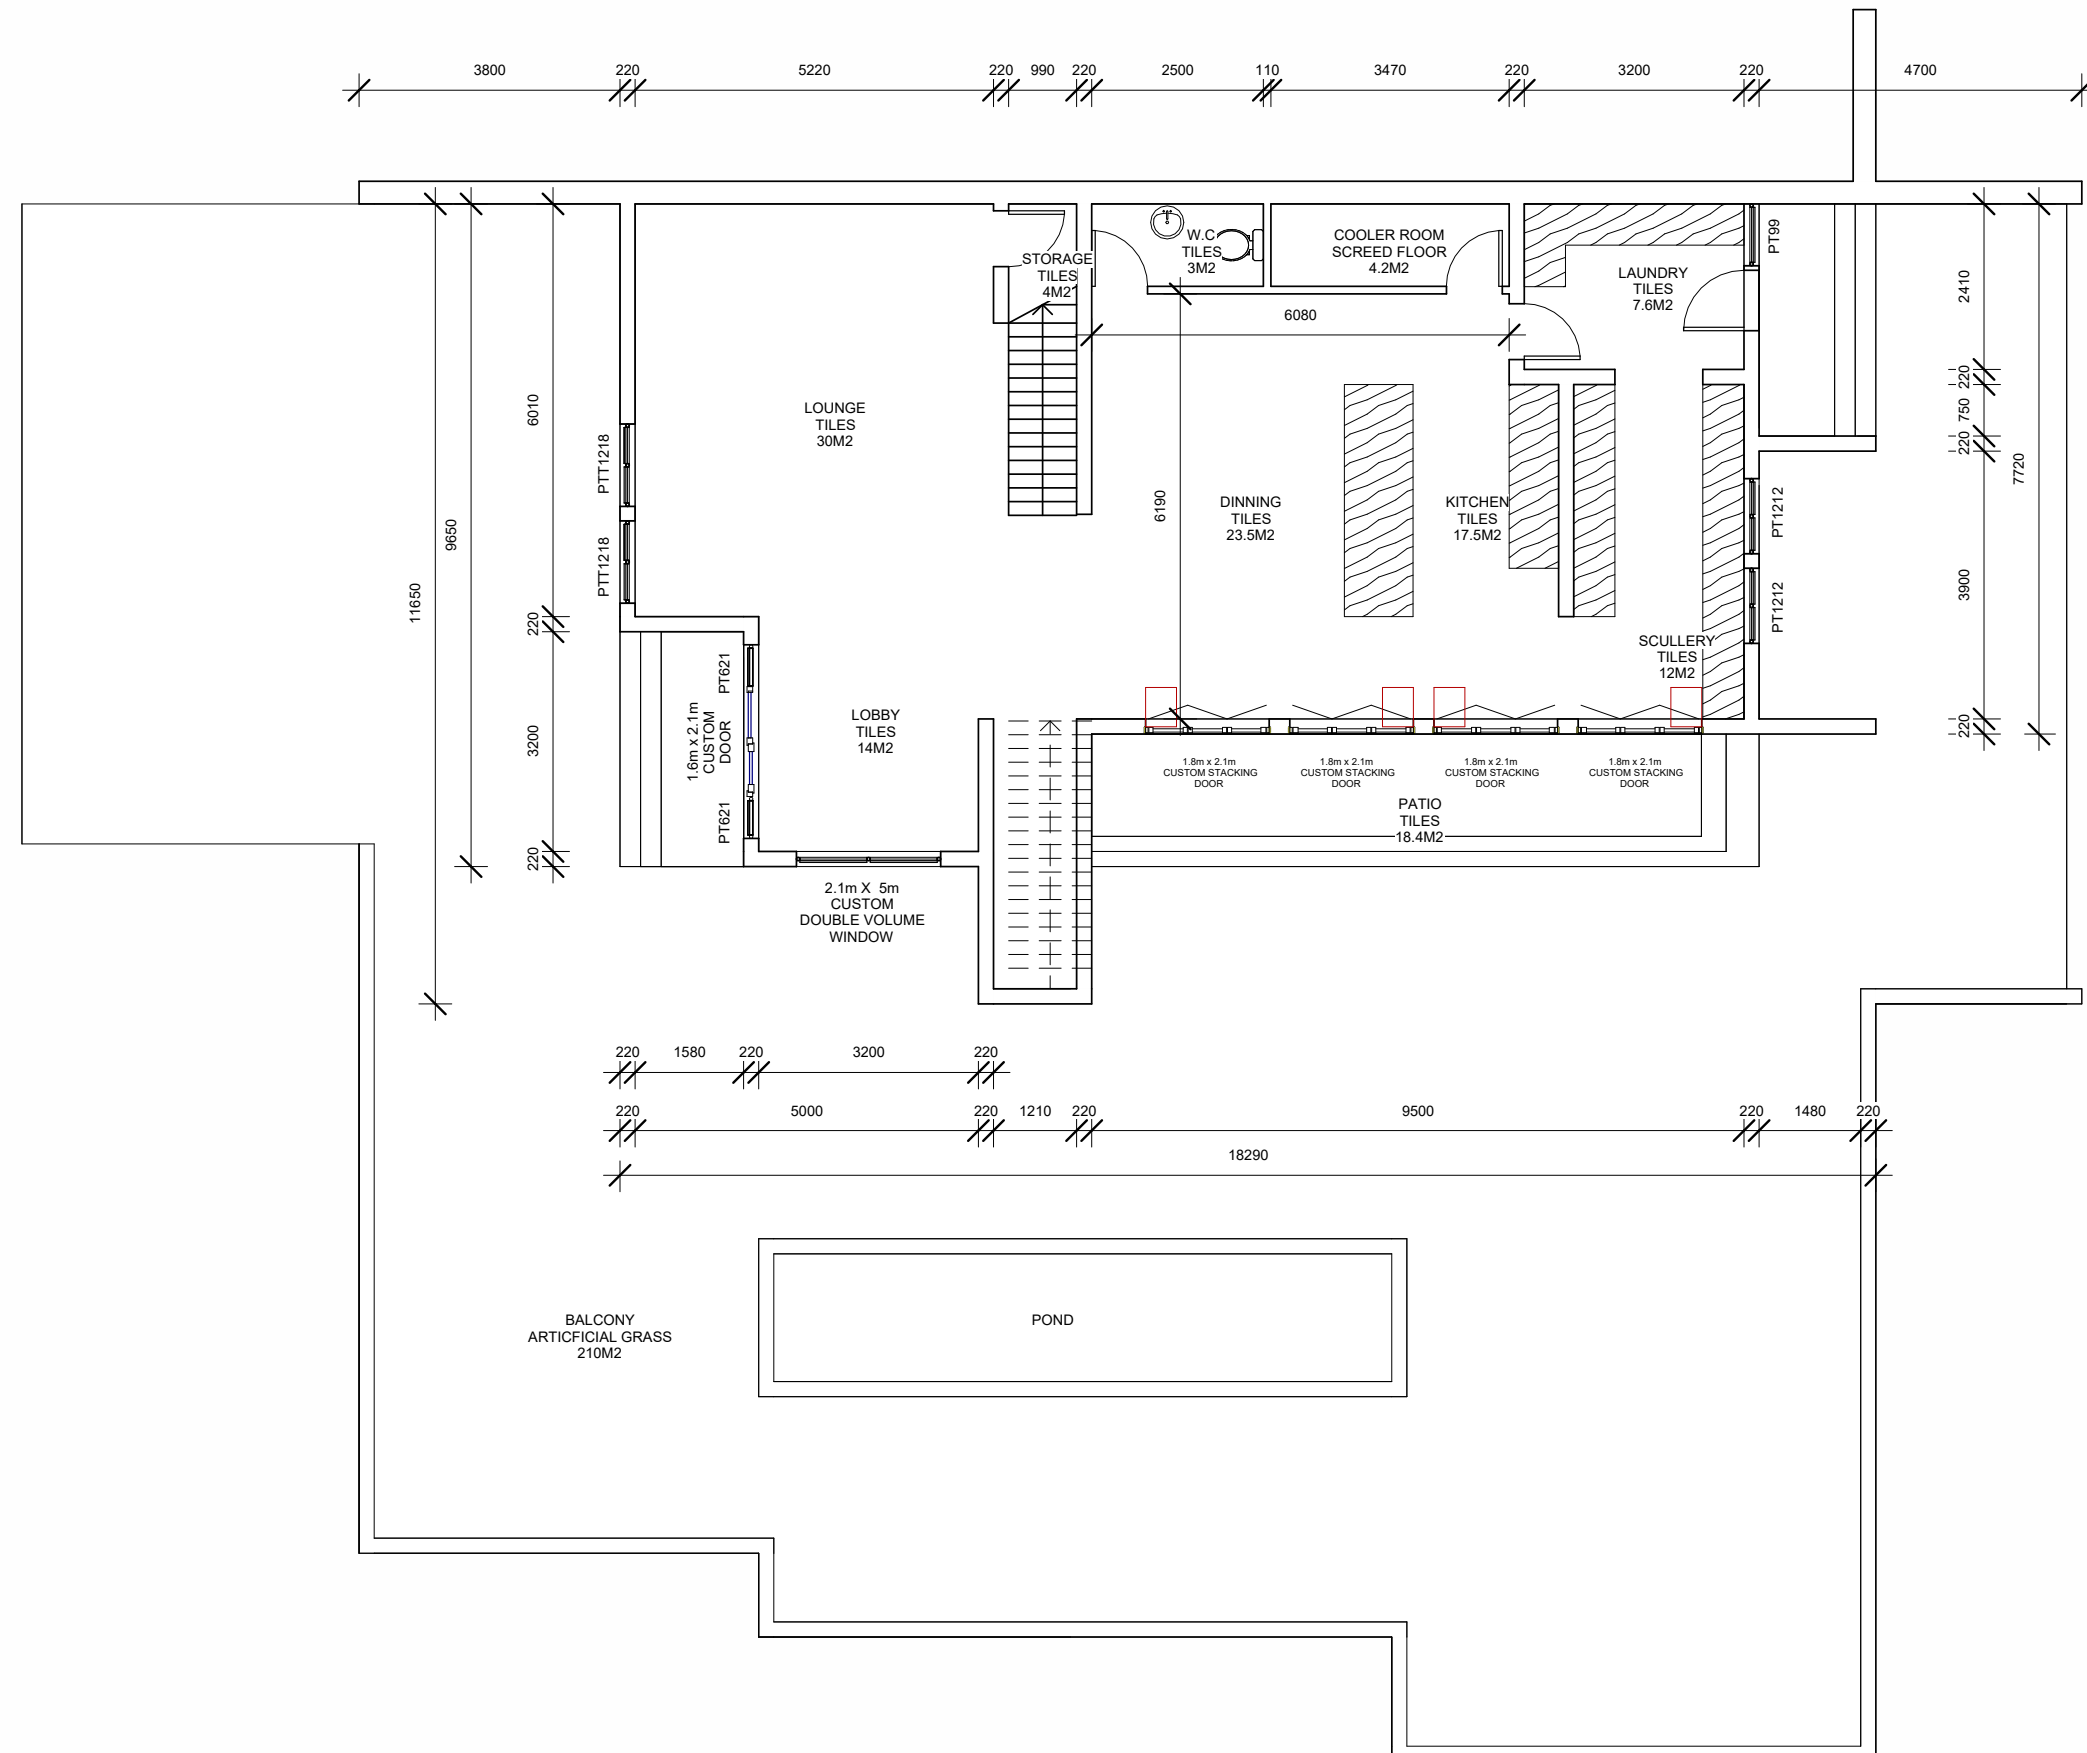


2 GROUND FLOOR

1 : 100

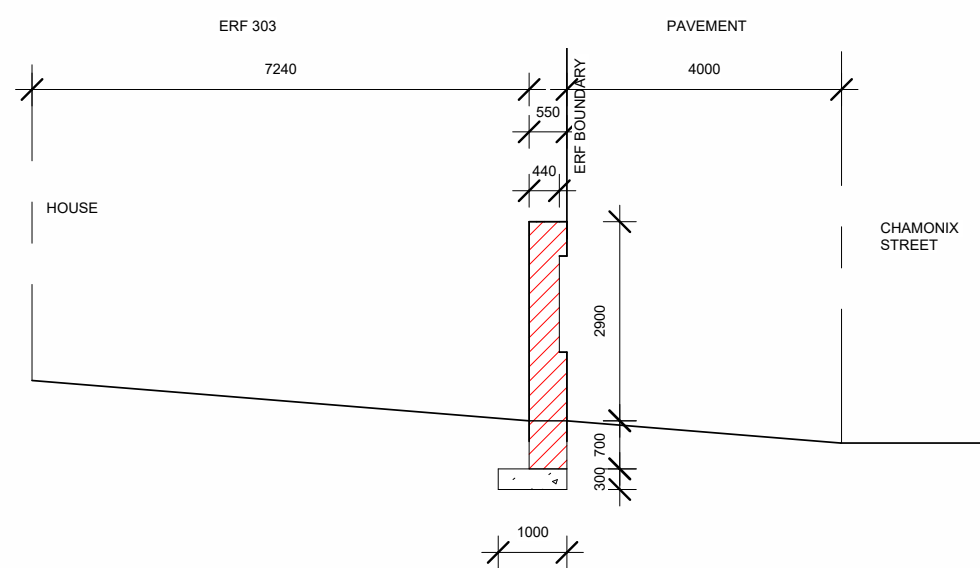

5 TYPICAL BOUNDARY WALL SECTION

1 : 100

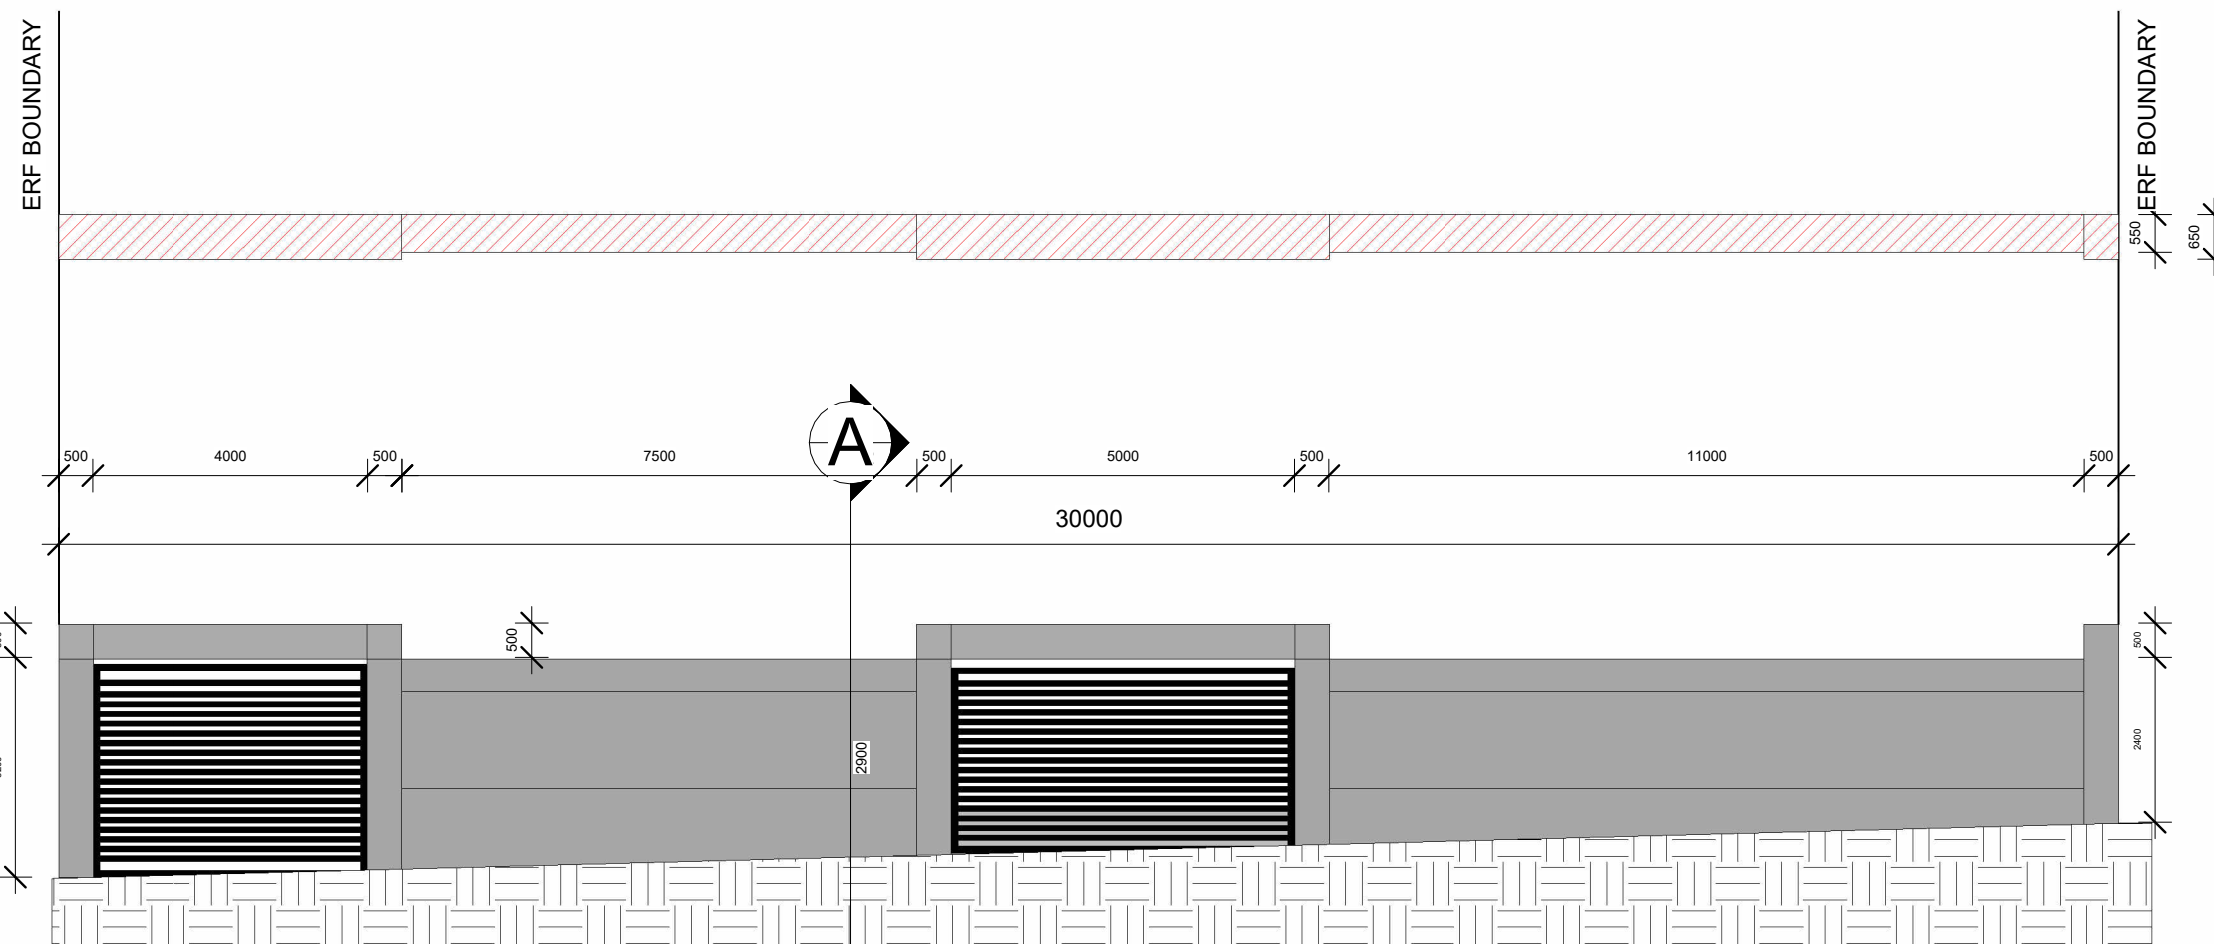

4 FRONT BOUNDARY WALL

1 : 100

DRAWING TITLE:

FOR MUNICIPAL SUBMISSION

LOWER FLOOR, GROUND FLOOR, FIRST FLOOR,  
NEW FRONT BOUNDARY WALL, DRIVEWAY SECTION/TYPICAL WALL  
SECTION

GENERAL NOTES:

1. ALL DIMENSIONS TO BE CHECKED ON SITE BEFORE ANY WORK IS PUT IN HAND.
2. THIS DRAWING TO BE READ IN CONJUNCTION WITH ENGINEER'S DRAWINGS.
3. UNDER NO CIRCUMSTANCES MAY DIMENSIONS BE SCALED FROM THIS DRAWING.
4. ANY DISCREPANCIES ARE TO BE REPORTED TO THE DESIGNERS IMMEDIATELY.

COPYRIGHT AND RIGHT OF REPRODUCTION OF  
THIS DRAWING OR ANY PORTION THEREOF IS  
RESERVED BY THE DESIGNER

CLIENT:

LI-YI CHEN &  
CHIA-JUNG CHANG  
  
P.O. BOX  
PIONIERSPARK  
+264 81 288 0708

PROJECT TITLE:

AS BUILT DRAWINGS

NEW FRONT BOUNDARY WALL, WINDOW AND DOOR CORRECTIONS

DATE:

05/05/2023

SCALE @ A1:

AS SHOWN

CLIENT APPROVED:

Y

DRAWING NUMBER

002/05

CHECKED BY:


L.AMUTENYA

DRAWN BY:

L.AMUTENYA

REV:

0

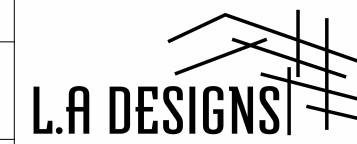

LANDULENI AMUTENYA  
P O Box 6933  
Ausserspitz  
l.a.designs@gmail.com